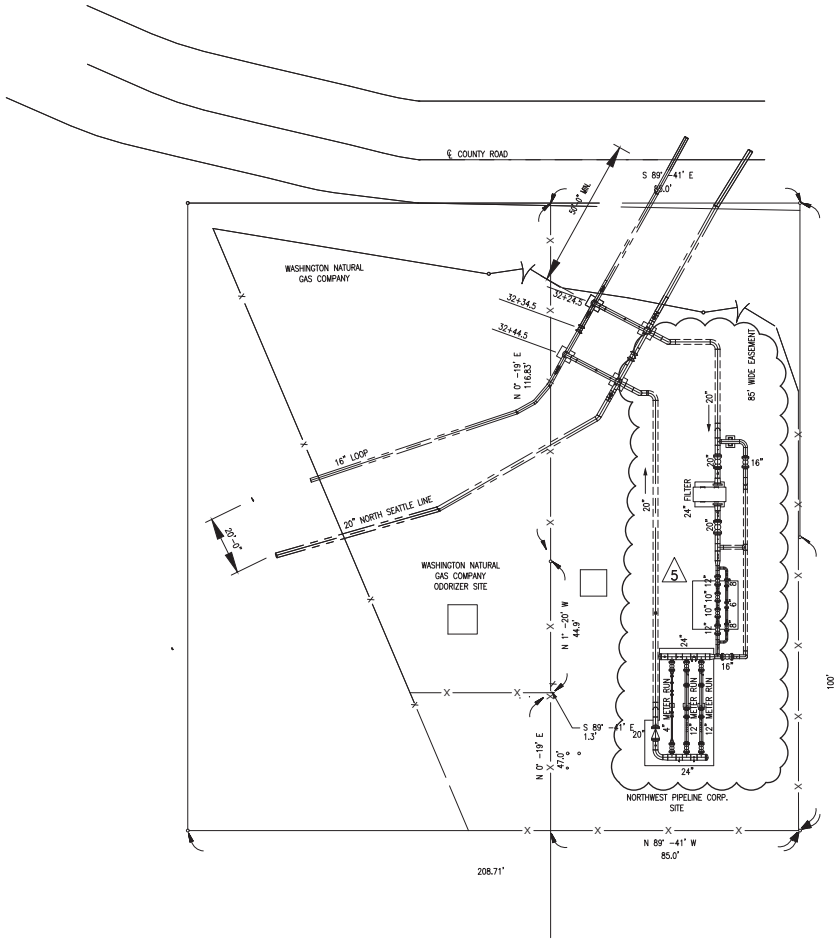

Figure 4

Approved for Permitting

REFERENCE DRAWINGS	
DRAWING NO.	TITLE
2428.0-1	ALIGMENT SHEET
PM5-NOS -P0001	P&ID
PM5--NOS-P0003	PIPING PLAN
PM5-NOS-P0004	PIPING SECTIONS
PM5-NOS-P0005	BILL OF MATERIAL
PM5-NOS-P0006	LINE TIE IN PIPING PLAN
PM5-NOS-P0007	LINE TIE IN SECTIONS & BOM
PM5-NOS-P0009	FILTER SECTIONS & DETAILS
PM5-NOW-P0011	BY-PASS PROCEDURE

REVISIONS						
NO.	DATE	BY	DESCRIPTION	W.O. NO.	CHK.	APP.
1	2-17-97	EGM	REDRAWN PER AS BUILT, CHG. DWG. No. FROM PM5-NOS-1	34461		
2	3-1-01	ASB	REVISED PER FIELDS MARK UPS			
3	4-24-08	RA	FILTER SEP. & TANK ADDED, REVISED PER REDLINES	1029094	CRC	
4	1-16-12	JBG	REPLACED REGULATION, FILTER INLET/OUTLET VALVES, & REMOVED ORIFICE	1094565	JPL	BG
5	06/27/13	TA	AS BUILT RAP#12-216	1094565	JBG	
6	10-4-18	JBG	NORTH SEATTLE UPGRADE	1094565		

NORTHWEST PIPELINE GP
NORTH SEATTLE LATERAL LINE
NORTH SEATTLE DELIVERY METER STATION

PLOT PLAN
SNOHOMISH COUNTY, WASHINGTON

GAS PIPELINE

DRAWN BY: EGM	DATE: 2-17-97	ISSUED FOR BID:	SCALE: 1" = 20'-0"
CHECKED BY: CRC	DATE: 2-97	ISSUED FOR CONSTRUCTION:	
APPROVED BY:	DATE:	DRAWING NUMBER: PM5-NOS-P0002	SHEET 1 OF 1